


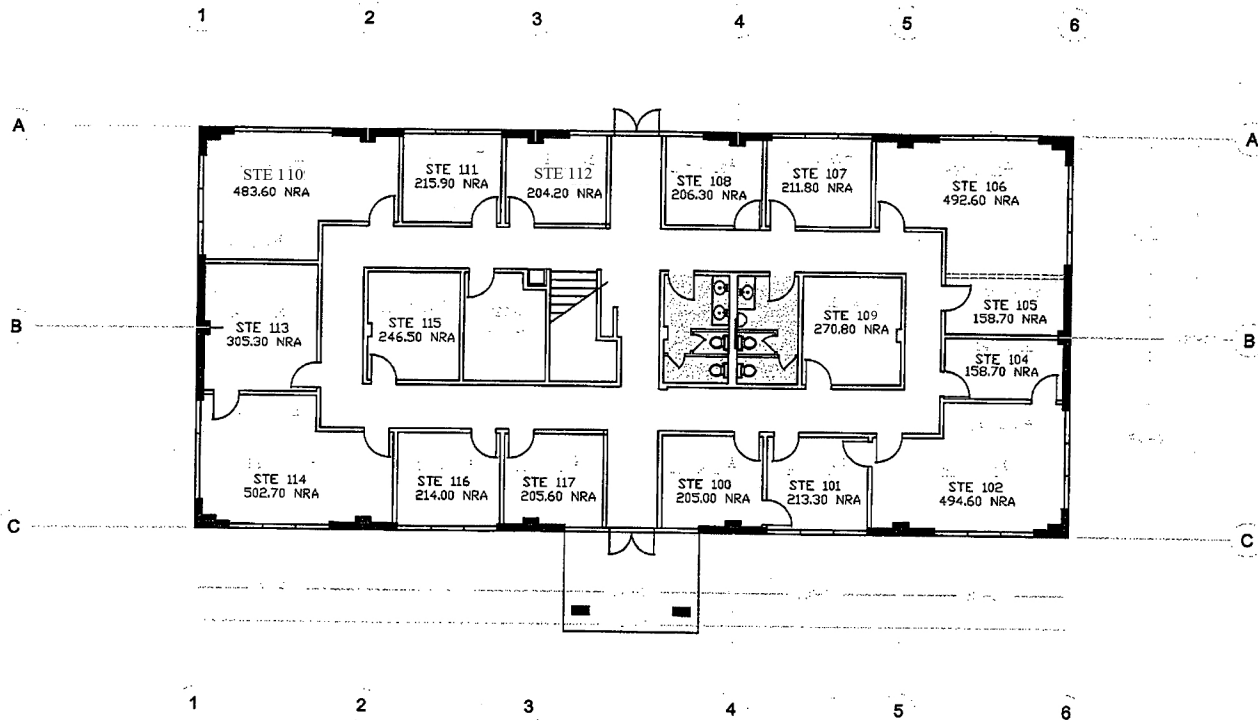

FLOOR PLAN - 1st FLOOR

SCALE: 1/8" = 1'-0"

North



#1931

HUMBLE PLACE DRIVE

BLDG. "F"

As Built Floor Plan

1-1-07 A-3