


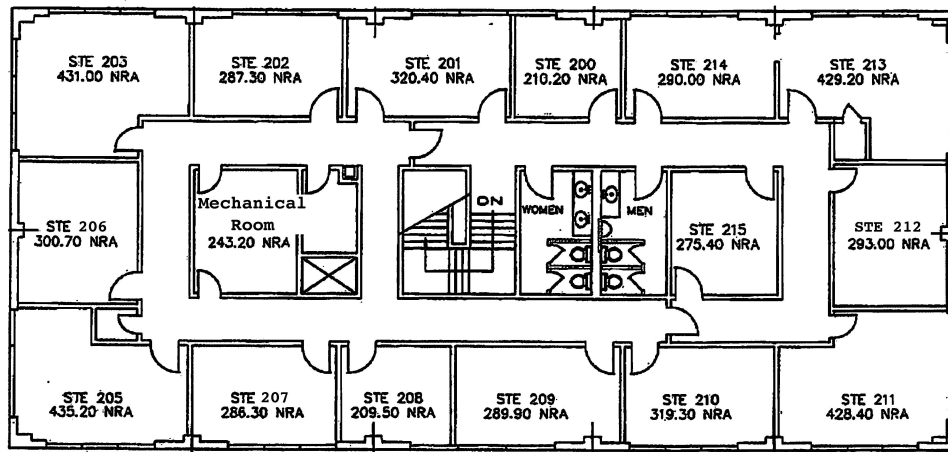

FLOOR PLAN - 2nd FLOOR

SCALE: 1" = 5' 0"



#1931

HUMBLE PLACE DRIVE

BLDG. "F"

As Built Floor Plan

4-3-87

A-2